
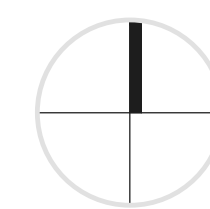


BASEMENT FLOOR PLAN
1/4" = 1'-0"

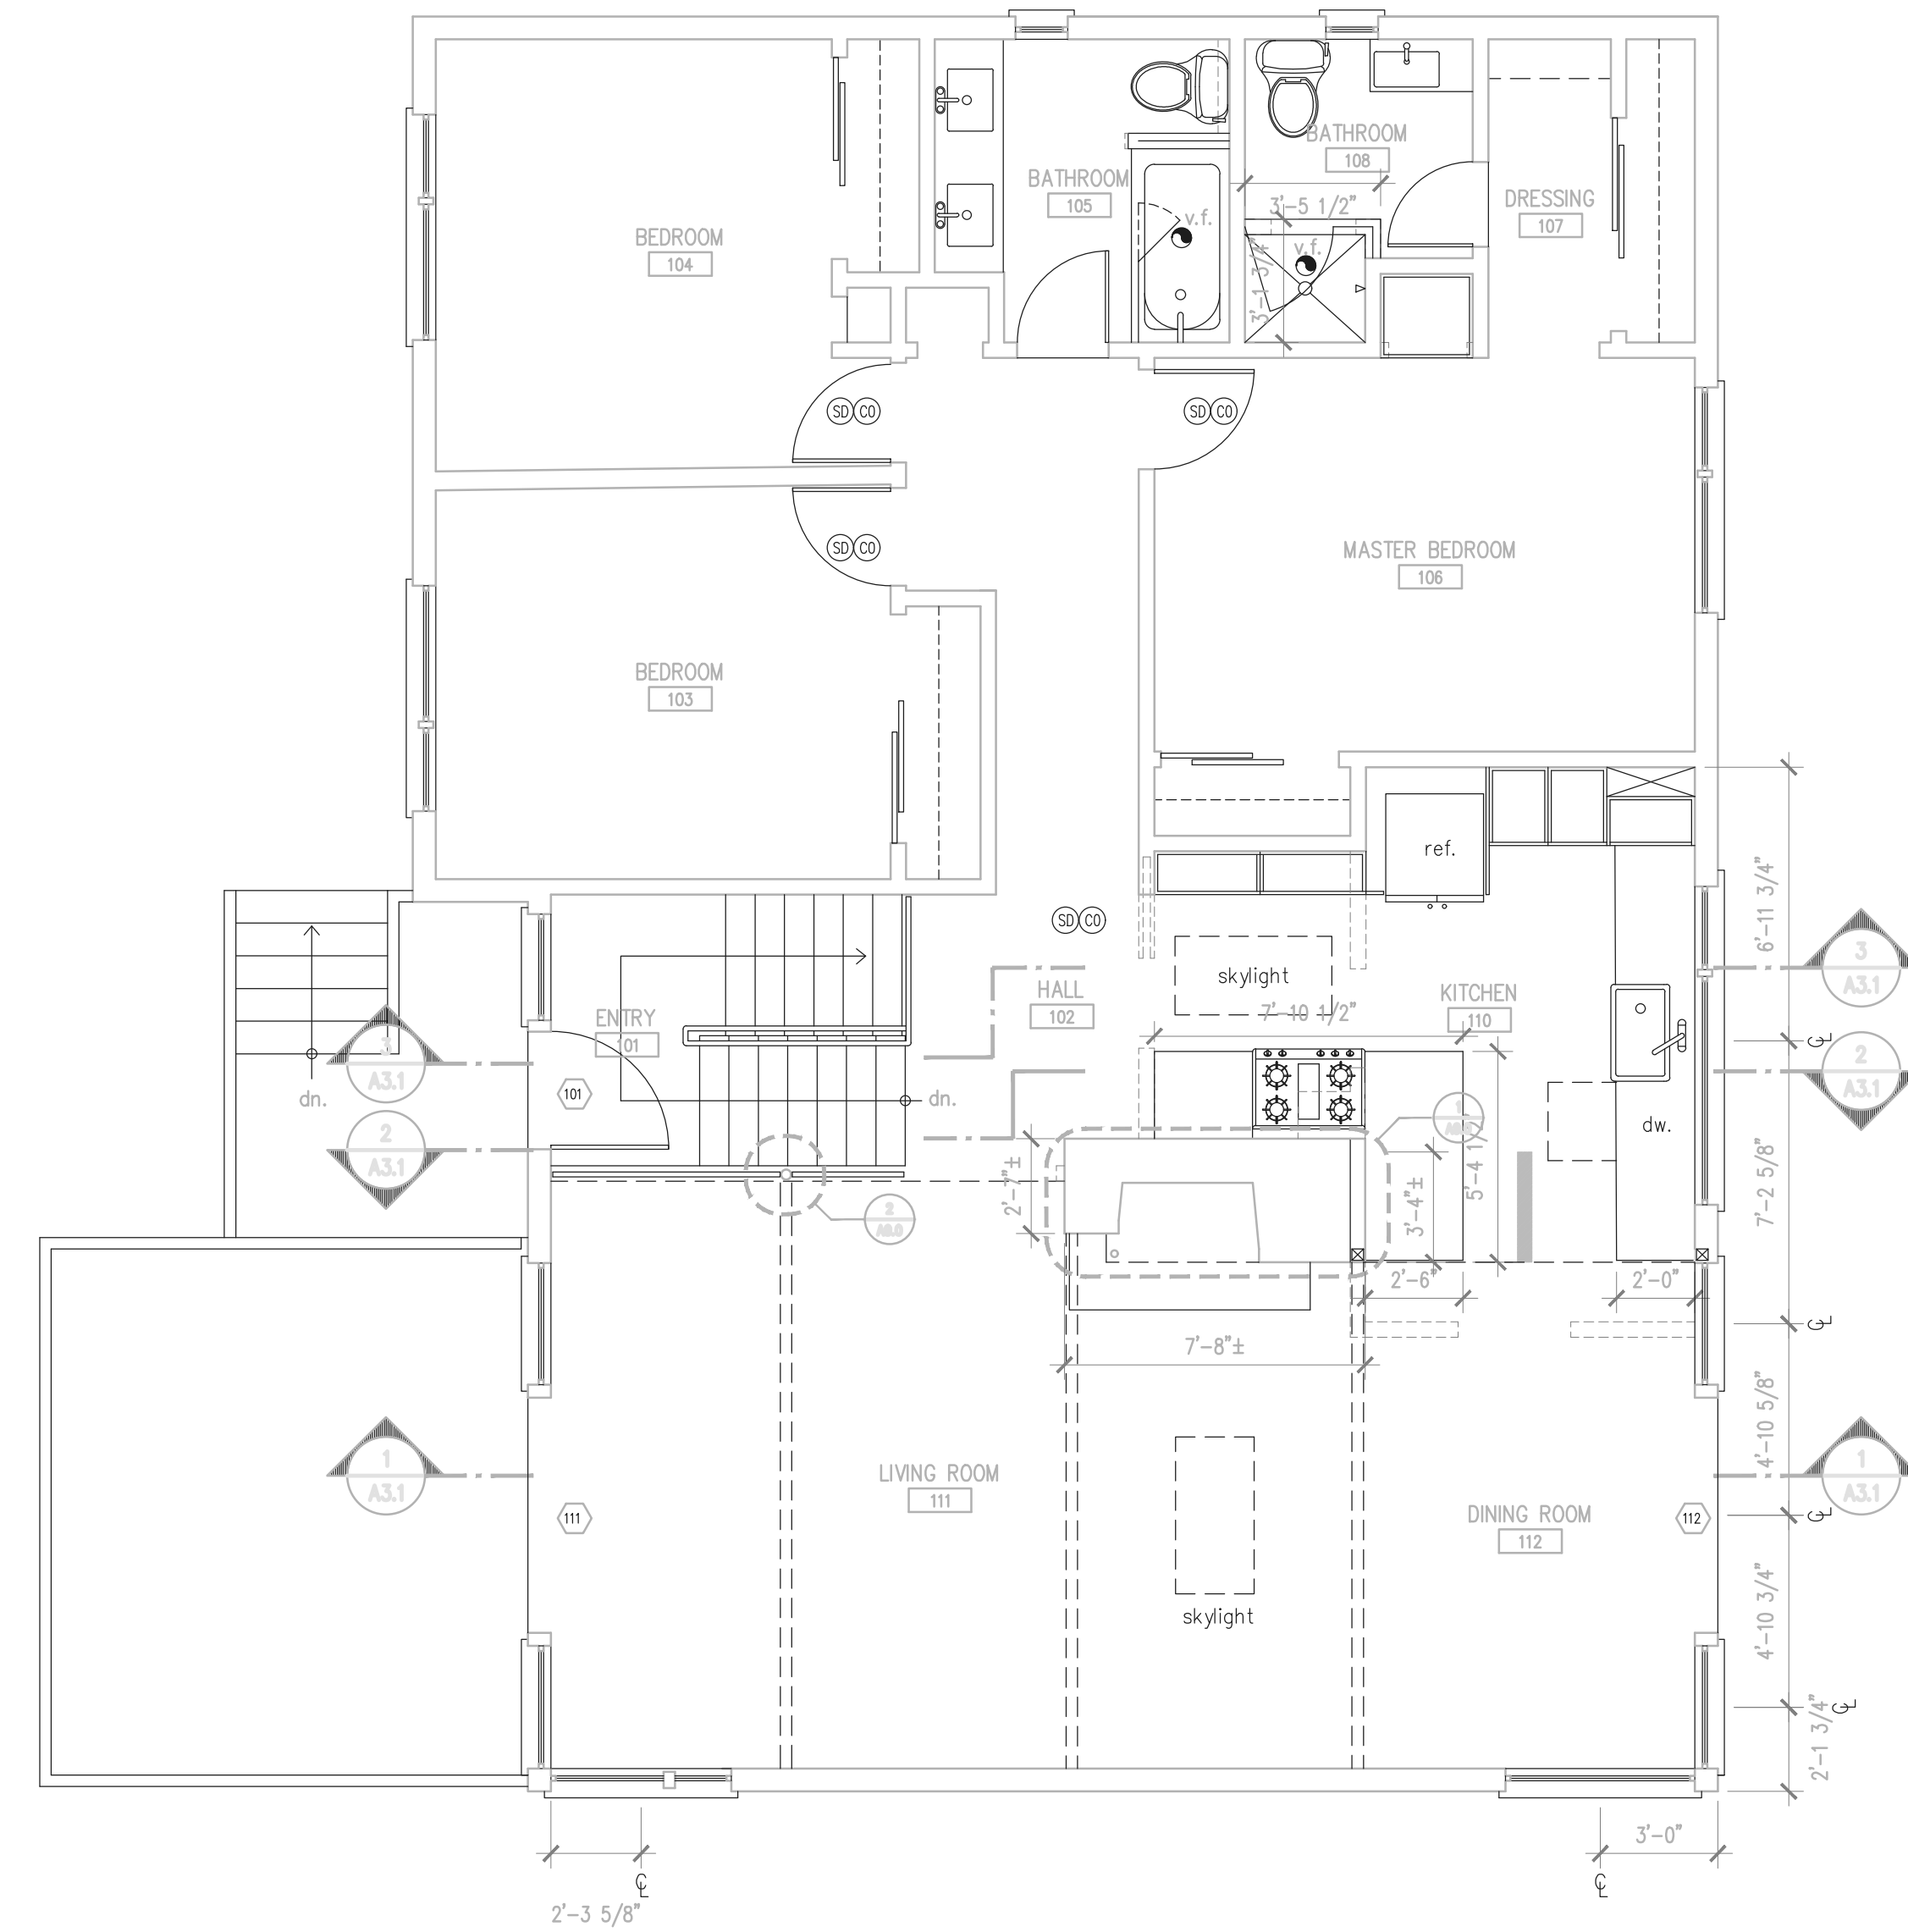

MAIN FLOOR PLAN
1/4" = 1'-0"

LEGEND

- EXISTING WALL TO BE DEMOLISHED
- ===== EXISTING WALL TO REMAIN
- ===== NEW WALL
- ⊙⊙ SMOKE & CO DETECTOR
- ⊙ VENT. FAN

GENERAL NOTES

1. DO NOT SCALE DRAWINGS.
2. ALL EXTERIOR WOOD TO BE PRESSURE TREATED OR NATURALLY IMPERVIOUS.
3. SMOKE DETECTORS TO BE HARDWIRED, WITH BATTERY BACK-UP, AUDIBLE THROUGHOUT HOUSE.
4. BATHROOM VENT FANS TO BE MINIMUM 50 CFM; KITCHEN VENT FAN TO BE MINIMUM 100 CFM.
5. ALL HANDRAILS TO BE 34-38" ABOVE TREAD NOSING. HANDRAIL GRASPING DIMENSION 1 1/2" MINIMUM TO 2" MAXIMUM 4" MAXIMUM CLEAR SPACE BETWEEN INTERMEDIATE RAILS.
6. SEE SHEET A7.0 FOR WINDOW SCHEDULE.

CONSTRUCTION SET

If this drawing is not 24" x 36" it is a reduced print


Revisions

No.	Description	Date

Drawn By: _____ Checked By: _____

FLOOR PLANS

 
Approval Stamp Space




Scale: _____ Drawing No. _____

Date: 12-07-17

Sheet No: **A2.0**

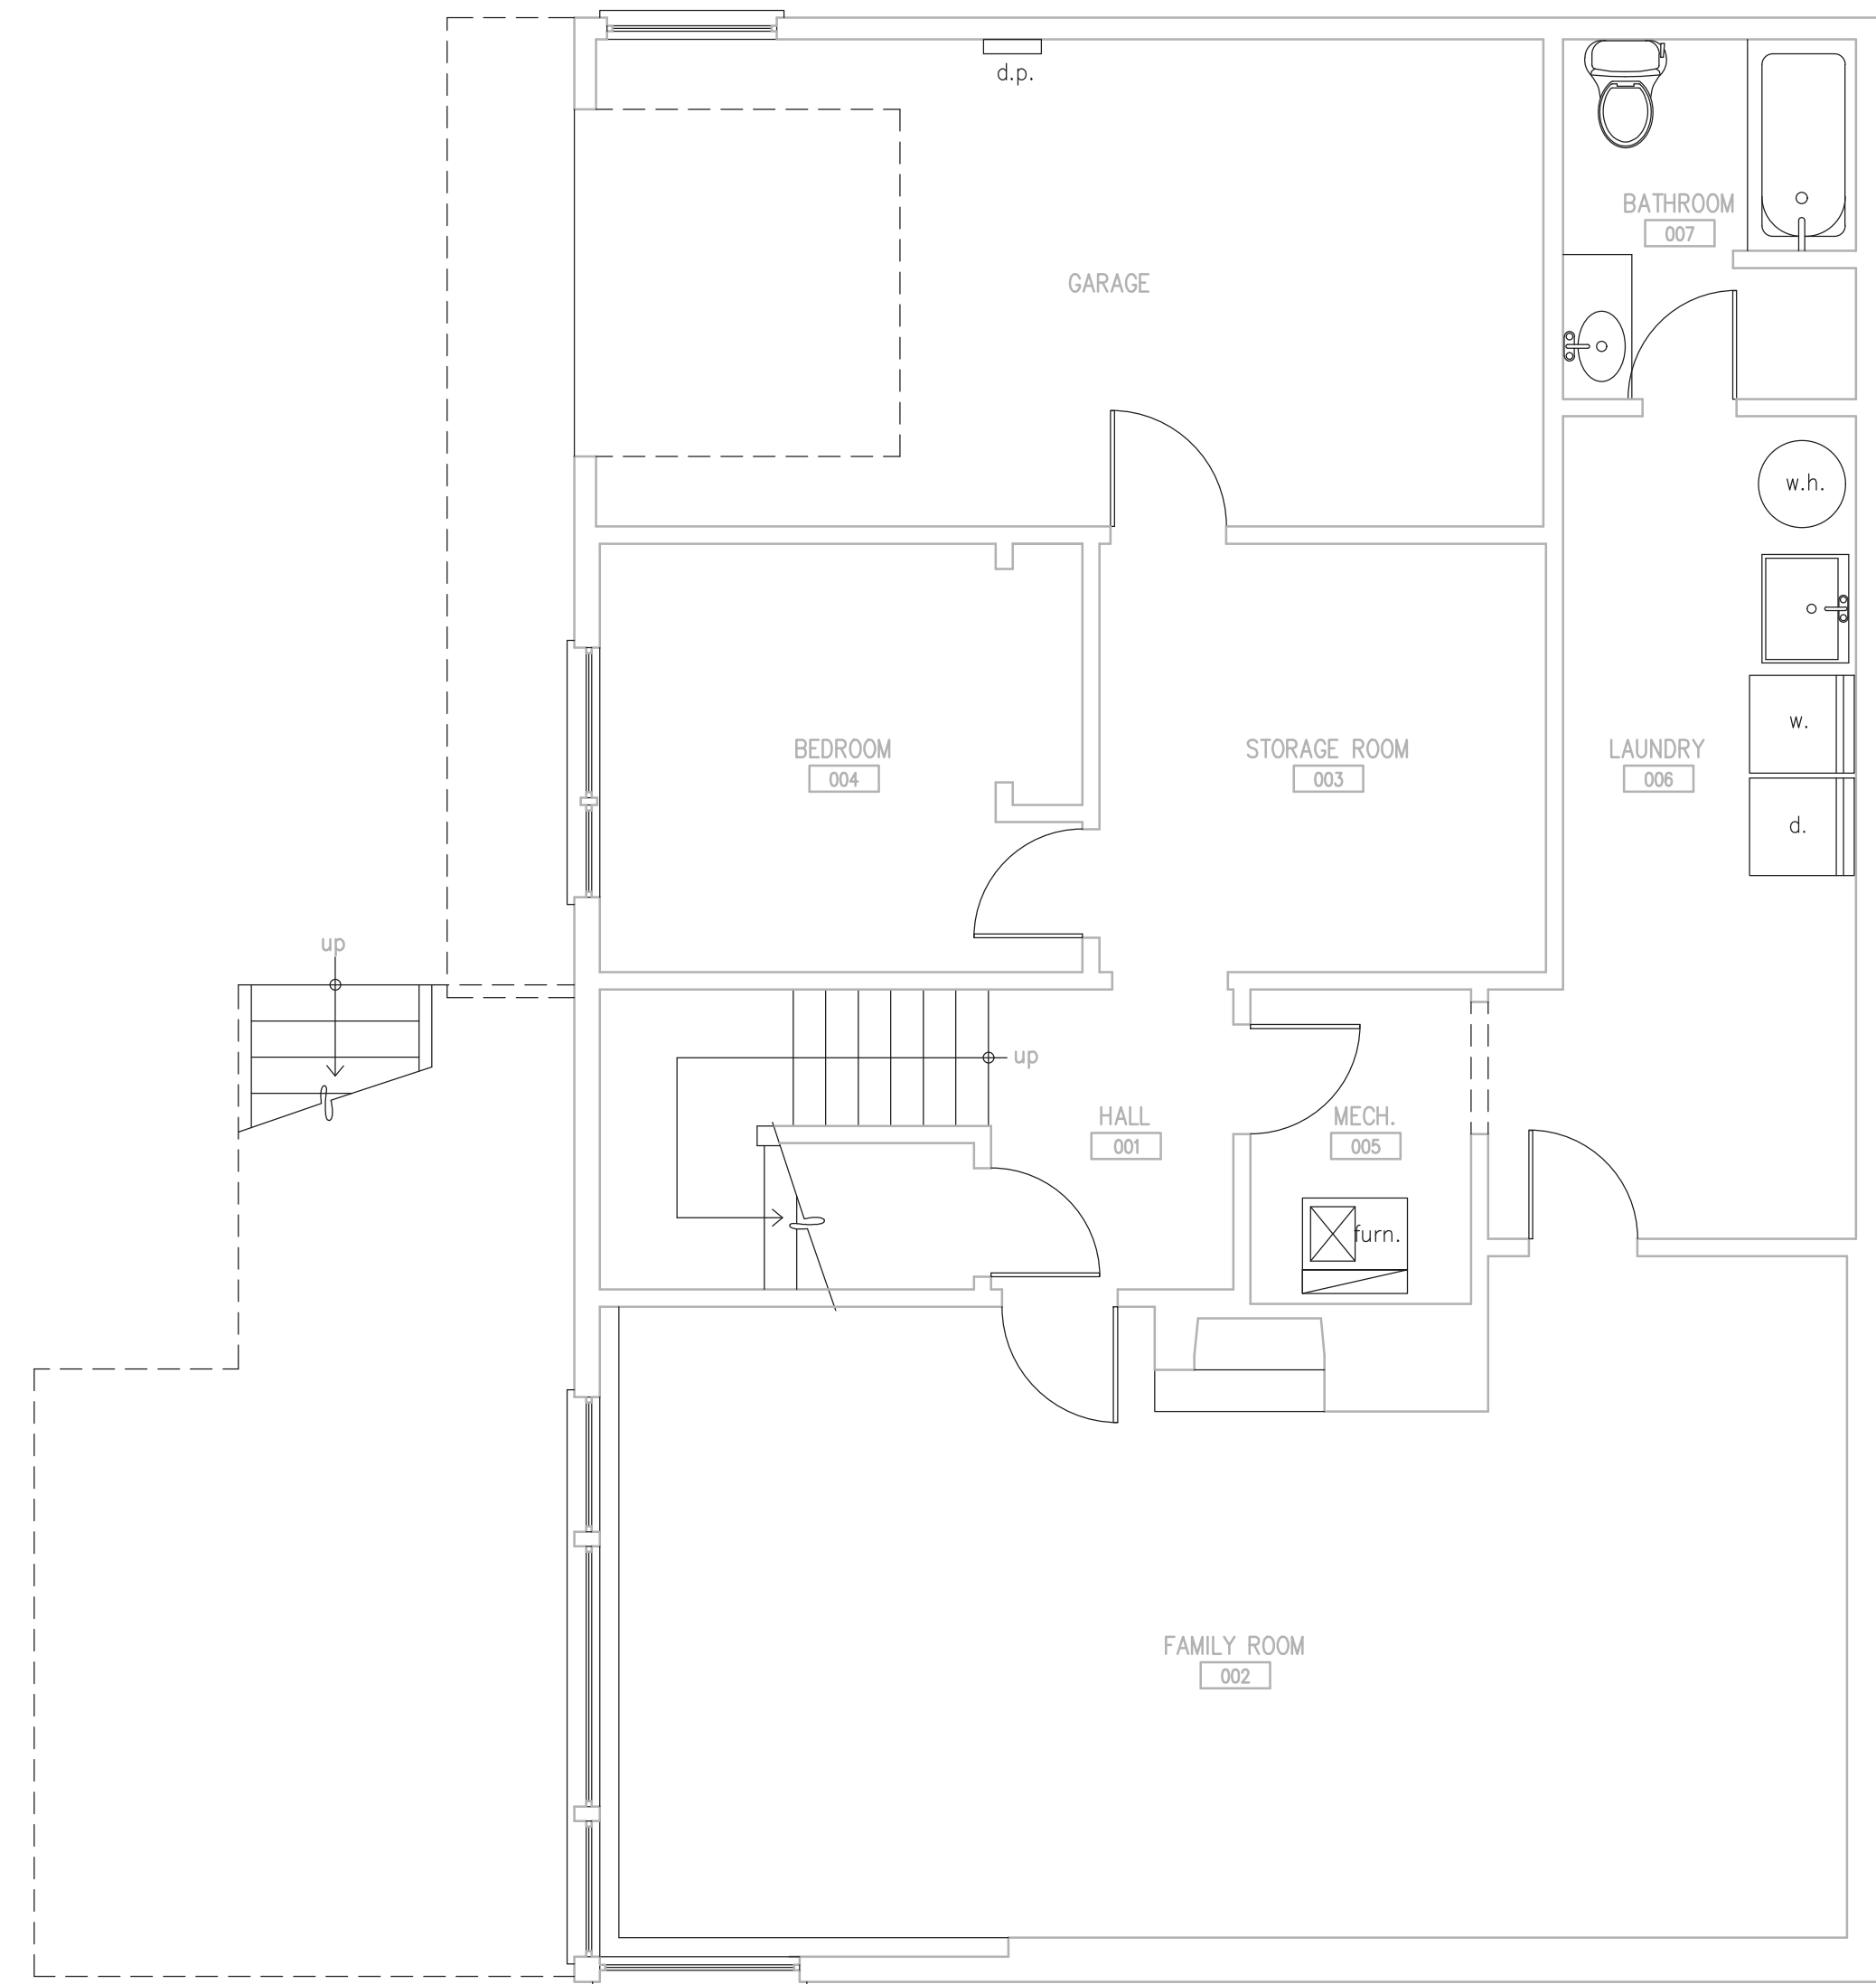

EXISTING BASEMENT PLAN
1/4" = 1'-0"

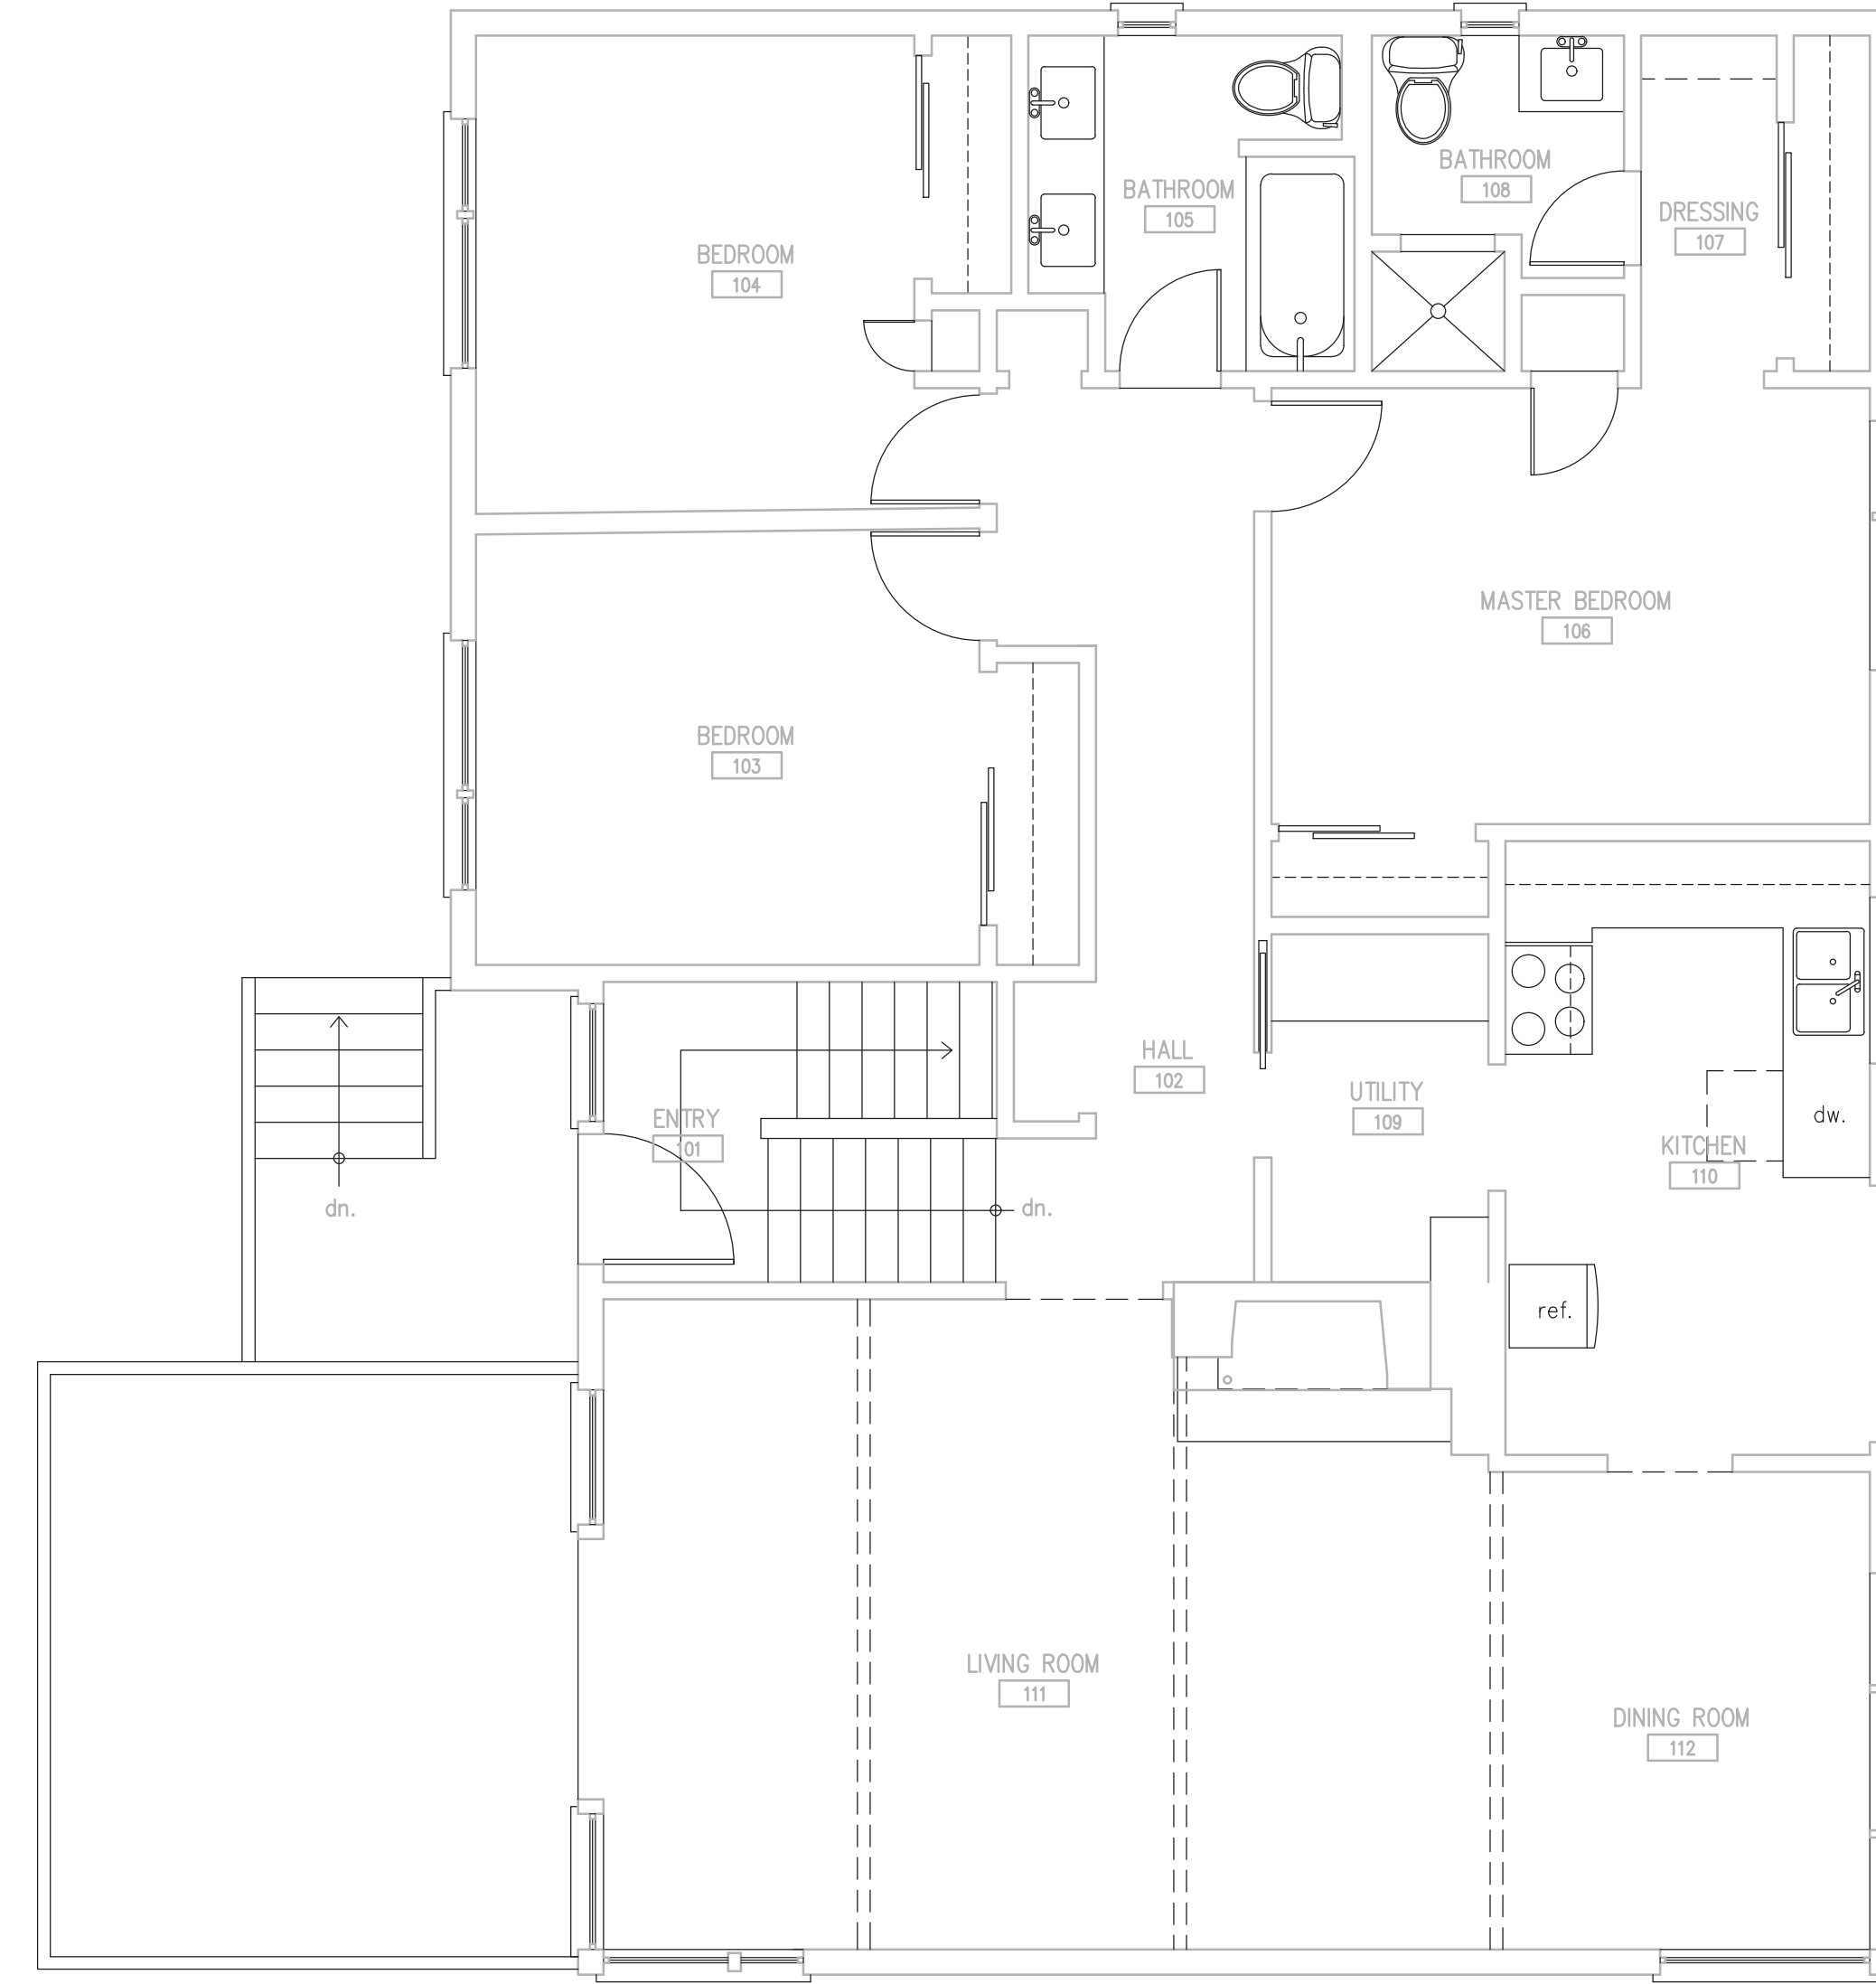

EXISTING MAIN FLOOR PLAN
1/4" = 1'-0"

NOT FOR CONSTRUCTION

If this drawing is not 24" x 36" it is a reduced print


Revisions

No.	Description	Date

Drawn By: _____ Checked By: _____

AS-BUILT PLANS

 Approval Stamp Space



Scale: _____ Drawing No. _____

Date: 02-08-17

Sheet No: **A2.0e**

All rights reserved. Material may not be reproduced in any form without permission from J.B. Inc.